

PATRICIA A. PESHKA
PURCHASING AGENT



SCOTT AVEDISIAN
MAYOR

CITY OF WARWICK
PURCHASING DIVISION
3275 POST ROAD
WARWICK, RHODE ISLAND 02886
TEL (401) 738-2000 EXT. 6240
FAX (401) 737-2364

To: All Prospective Bidders

From: Patricia A. Peshka, Purchasing Agent

Date: March 22, 2016

Re: **Bid #2016-269 Fire Alarm Upgrades at Cooper Building & Detached Maintenance Shop**

Addendum #2

Attached please find addendum #2 for the above-named project.

An opening date has yet to be determined.

Should you have any questions, please contact Joseph Blake, Building Maintenance, at 401-738-2000, extension 6350.

Thank you for your interest in this project.

TO: All Bidders
FROM: Joseph J. Watson, PE
SUBJECT: Bid #2016-269 Fire Alarm Upgrades Cooper Building
DATE: March 21, 2016
CC: Joseph Blake – City of Warwick

Please include the following clarifications to the City of Warwick Phase IV Fire Alarm plans (Bid #2016-269). This document shall supplement Construction Documents dated January 28, 2016.

The Contractor shall complete the following scope of work:

1. The work times for the project shall be between 7:00 am and 3:00 pm and may be extended upon written approval from the Owner and Engineer.
2. All fees associated with the installation of the fire alarm systems shall be included in the bid. Plan review and permit fees will NOT be waived by the City of Warwick. The Contractor shall pay all plan review and permit fees.
3. **REVISE** the fire alarm system layout in the Maintenance Garage as shown on Sheet FA-1.2.
4. The Contact Information for the City of Warwick's Honeywell representative is as follows:

William (Bill) Place
Account Executive
2000 Plainfield Pike
Cranston, RI 02921
Email: William.place@honeywell.com
Office: 401-275-2658
Mobile: 401-640-6652


All bidders must acknowledge acceptance of this addendum in their bid.

Please do not hesitate to contact our office with any questions.

Attachment: Sheet FA-1.2

THIS DOCUMENT IS THE PROPERTY OF JENSEN HUGHES AND IS TO BE USED ONLY FOR THE PROJECT AND LOCATION IDENTIFIED HEREIN. IT IS TO BE KEPT IN THE PROJECT FILE AND NOT REPRODUCED OR TRANSMITTED IN ANY FORM OR BY ANY MEANS, ELECTRONIC OR MECHANICAL, INCLUDING PHOTOCOPYING, RECORDING, OR BY ANY INFORMATION STORAGE AND RETRIEVAL SYSTEM.

PROJECT	FIRE ALARM UPGRADES PHASE IV - COOPER BUILDING
OWNER	COOPER, WASHY LANE WARWICK, RI
DESIGNED BY	JENSEN HUGHES
DATE	JANUARY 28, 2015
SCALE	AS SHOWN
PROJECT NO.	1501
SHEET NO.	1
TOTAL SHEETS	2
DATE	JANUARY 28, 2015
SCALE	AS SHOWN
PROJECT	FIRE ALARM UPGRADES PHASE IV - COOPER BUILDING
OWNER	COOPER, WASHY LANE WARWICK, RI
DESIGNED BY	JENSEN HUGHES
DATE	JANUARY 28, 2015
SCALE	AS SHOWN
PROJECT NO.	1501
SHEET NO.	1
TOTAL SHEETS	2

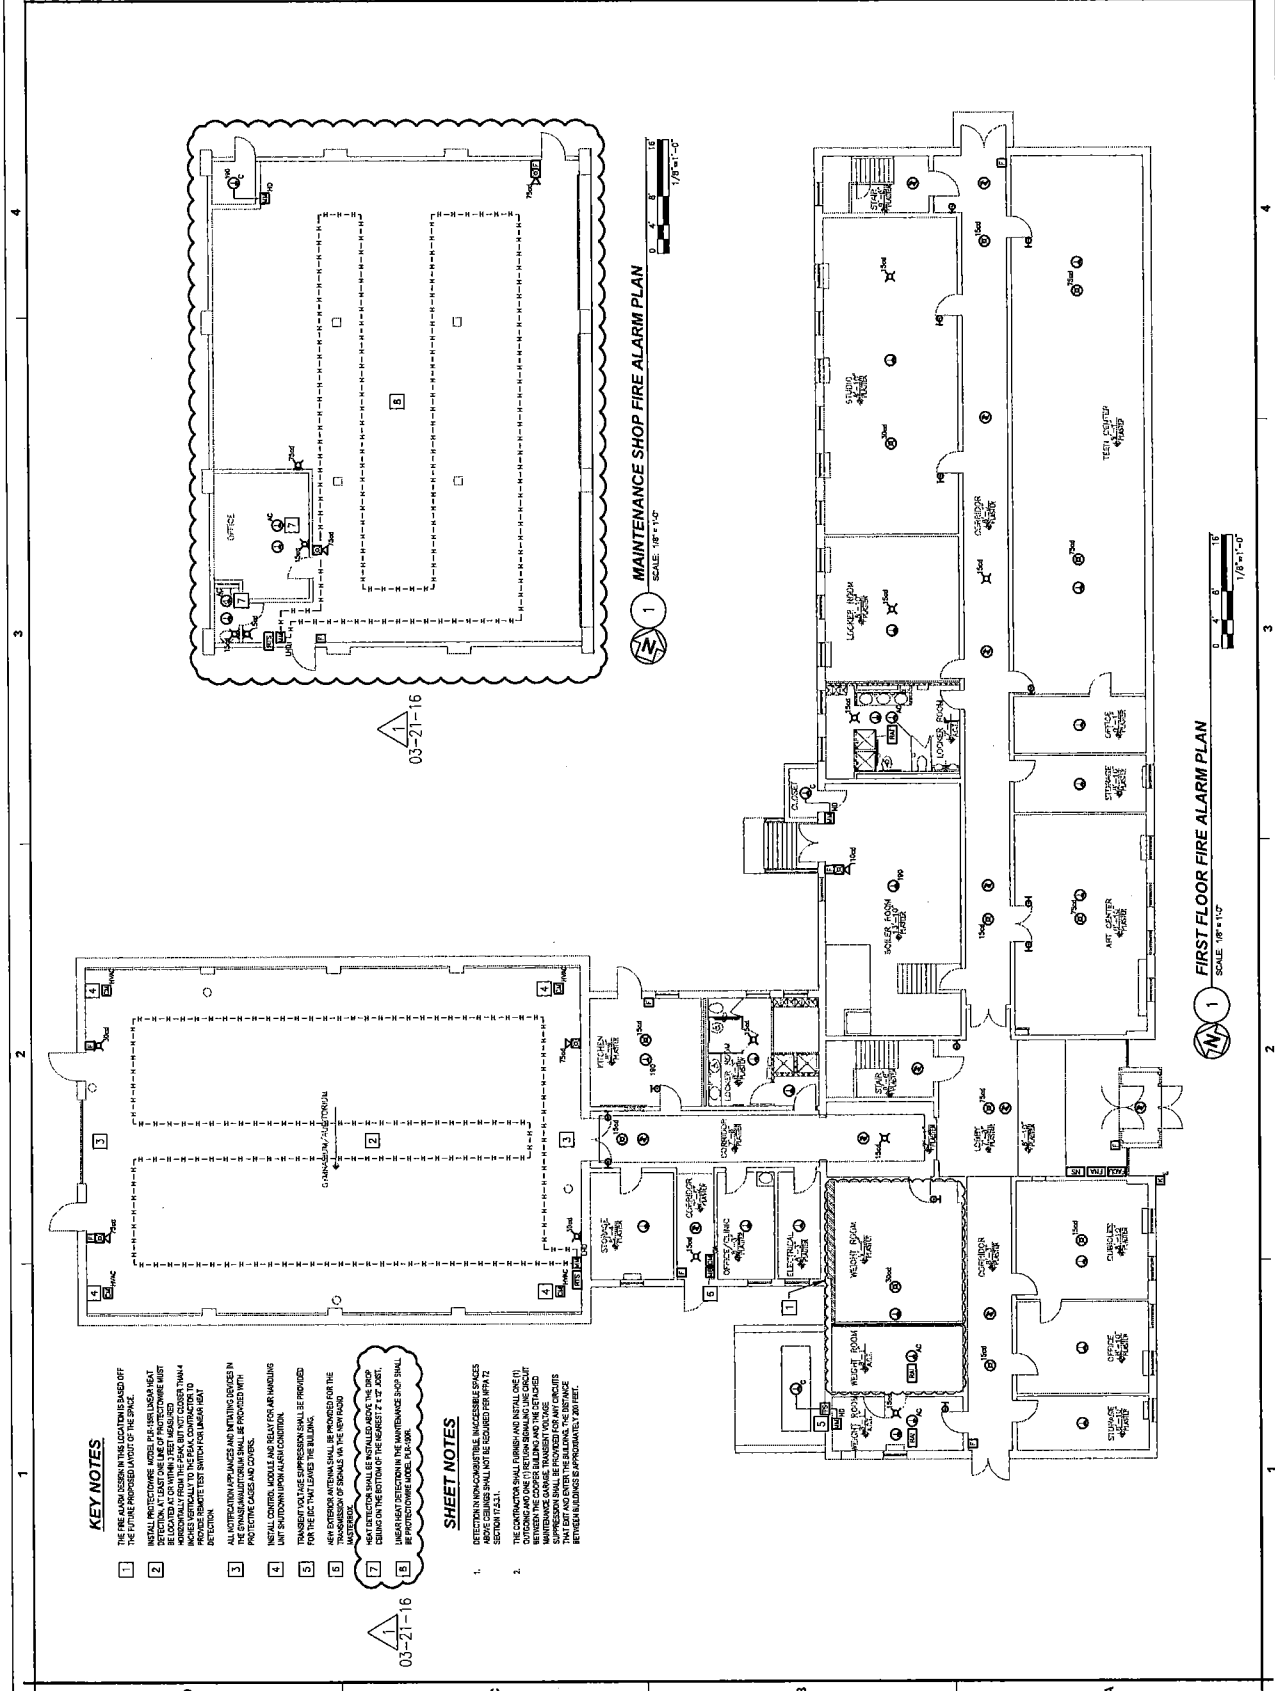

KEY NOTES

- 1 THE FIRE ALARM DEVICES IN THIS LOCATION IS BASED OFF THE FUTURE PROPOSED LAYOUT OF THE SPACE.
- 2 INSTALL PROTECTIVE MODEL PIPER LASKER HEAT DETECTORS IN THE MAINTENANCE SHOP. THE DETECTORS MUST BE LOCATED AT CEILING TRUSS LEVEL AND MUST BE HANGING FROM THE TRUSS, BUT NOT CLOSER THAN 4 FEET TO THE WALLS. THE DETECTORS MUST BE PROTECTED BY A 1/2" THICK PROTECTIVE REMOTE TEST SWITCH FOR LASKER HEAT DETECTION.
- 3 ALL DETECTION APPLIANCES AND INITIATING DEVICES IN THIS LOCATION SHALL BE PROVIDED WITH A 1/2" THICK PROTECTIVE REMOTE TEST SWITCH FOR LASKER HEAT DETECTION.
- 4 INSTALL COXSON LASKER HEAT DETECTOR FOR HANDLING UNIT SHUTDOWN ALARM CONDITION.
- 5 TRANSDUCER VOLTAGE SUPPRESSION SHALL BE PROVIDED FOR THE FACT THAT LEAVES THE BUILDING.
- 6 A 1/2" THICK PROTECTIVE REMOTE TEST SWITCH FOR THE TRANSDUCER OF SIGNALS VIA THE NETWORK.
- 7 THE DETECTION DEVICES IN THE MAINTENANCE SHOP SHALL BE PROTECTIVE MODEL PIPER LASKER HEAT DETECTORS.

SHEET NOTES

- 1 DETECTION IN NON-COMBUSTIBLE UNACCESSIBLE SPACES ABOVE CEILING SHALL NOT BE REQUIRED FOR NFPA 72 SECTION 7.5.1.1.
- 2 THE CONTRACTOR SHALL FURNISH AND INSTALL ONE (1) DETECTOR IN THE MAINTENANCE SHOP AND THE DETECTOR WITHIN THE COOPER BUILDING AND THE DETECTOR WITHIN THE MAINTENANCE SHOP SHALL BE PROTECTED BY A 1/2" THICK PROTECTIVE REMOTE TEST SWITCH FOR LASKER HEAT DETECTION THAT IS NOT AND CENTER THE BUILDING. THE DISTANCE BETWEEN BUILDINGS IS APPROXIMATELY 100 FEET.

03-21-16

MAINTENANCE SHOP FIRE ALARM PLAN
SCALE: 1/8"=1'-0"

FIRST FLOOR FIRE ALARM PLAN
SCALE: 1/8"=1'-0"

FA-1.2